



Project: 720056: Iqaluit Water Treatment Plant – Fuel Tank Replacement	
RFT No.: 2023-RFT-057	
Addendum No. 01	No. of Pages: 2
Date: March 13, 2023	Doc. No.: P7201-1189411283-53(1.0)

The following change(s) in the Request for Tender Documents No. 2023-RFT-057 are effective immediately.

This Addendum forms part of the Contract Documents.

ITEM	DESCRIPTION	ACTION
------	-------------	--------

Question 1:

2.1.5, Please provide further details of how we are integrating with the SCADA system. Is the current day tank float an equal change to the new day tank float, so no reprogramming is required? Only wiring changes.

Response 1:

This is correct for the day tank level switch so no need for new integration with the SCADA as it is a simple switch from one brand to another.


But this is not the only instrument that needs to be linked to SCADA. New instruments that go on the external tank need to be integrated into Scada so the operator can monitor the level of the bulk tank outside.

Question 2:

Can WSP provide the final elevations of the concrete slab, along with the existing elevations of the ground. This information is essential in light of the fact that there is a road leading through this area, which is on a downslope. Please refer to the attached dwg P01, which contains markups that will help further illustrate our request.


Response 2:

Enclosed

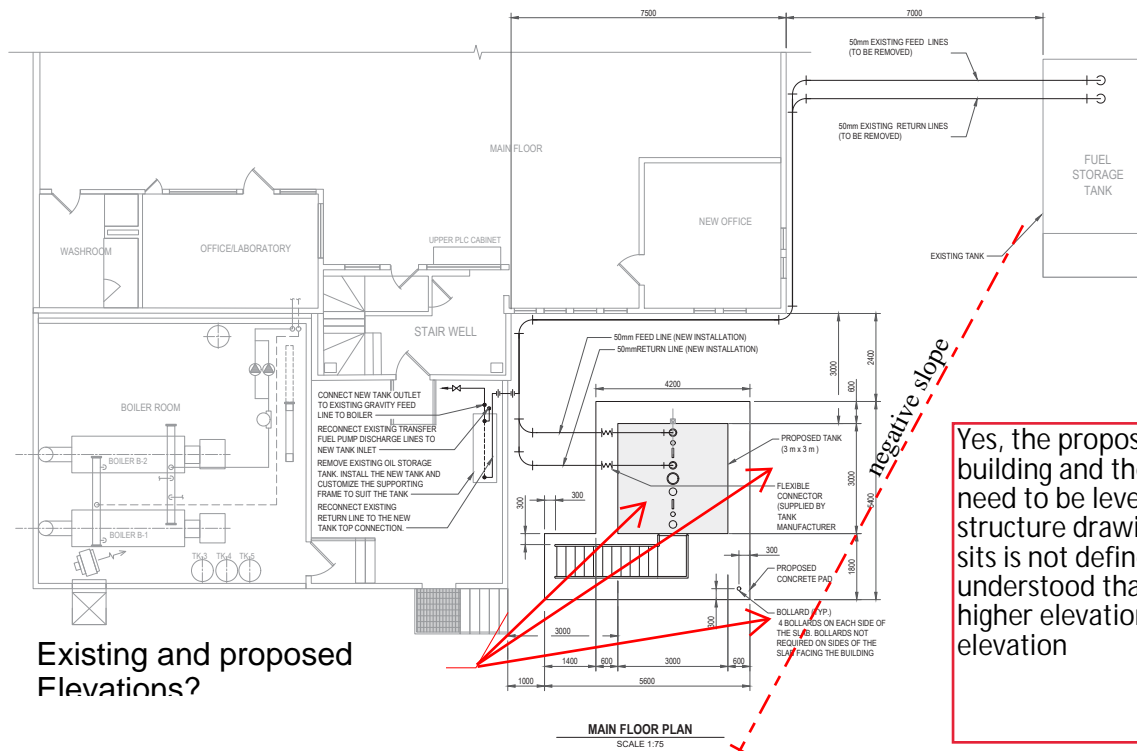

Existing and proposed Elevations?

Yes, the proposed tank is on a slope towards the building and the areas where the concrete pad, will need to be levelled up and compacted as per the structure drawing. The ground level where the pad sits is not defined as it is not critical and it is understood that the existing fuel tank is at a much higher elevation but not trying to match any elevation

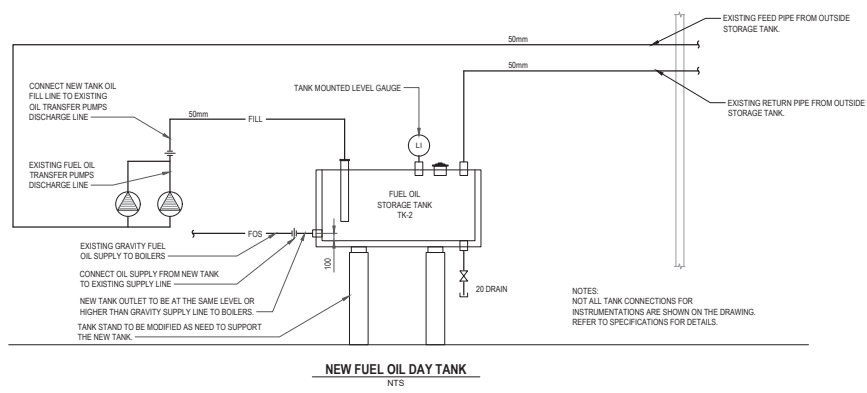

REV	DATE	DESCRIPTION	BY
0	2023-02-24	ISSUED FOR TENDER	HA

SEAL:

DISCLAIMER: THIS DRAWING AND DESIGN IS COPYRIGHT PROTECTED WHICH SHALL NOT BE REPRODUCED OR REVISED WITHOUT WRITTEN PERMISSION BY WSP. THE CONTRACTOR SHALL CHECK AND VERIFY ALL DIMENSIONS AND UTILITY LOCATIONS AND REPORT ALL ERRORS AND OMISSIONS PRIOR TO COMMENCING WORK.

PROJECT NO: AS SHOWN
 APPROVED BY: PIA
 CHECKED BY: PIA
 DESIGNER/OPTIONAL: ES

DATE: 2023-02-24
 IF THIS BAR IS NOT 25mm LONG, ADJUST YOUR PLOTTING SCALE.

DISCIPLINE:

WSP Canada Inc.
 1600 BUFFALO PLACE, WINNIPEG, MANITOBA CANADA R3T 6B8
 T: 204-477-8550 | www.wsp.com

PROJECT NUMBER: 201-09487-00

CLIENT: CITY OF IQALUIT

CLIENT REF. #:

PROJECT: WATER TREATMENT PLANT

TITLE: TANK REPLACEMENT ARRANGEMENT AND P&ID

DRAWING NUMBER: P01

REV: 0

C:\Users\paul.m\OneDrive\Documents\Projects\2023\2023-02-24_11:16:04
 2023-02-24 11:16:04
 2023-02-24 11:16:04