

CORPORATION OF THE TOWN OF IQALUIT  
BY-LAW # 362

A **BY-LAW** of the Incorporated Town of Iqaluit to open a municipal road pursuant to NWT Cities, Towns and Villages Act Sections 75 & 77.

**NOW THEREFORE** the Council of the Town of Iqaluit, in a meeting duly assembled, enacts as follows:

SHORT TITLE

1. This by-law shall be known as the Apex Subdivision Road Closure By-Law

DESCRIPTION

2. The road to be closed to all vehicular traffic is all that portion of the road shown on the legal plan #71735 CLSR, and crossing the newly created lots Block 6, Lot 3, Block 7, Lots 8,9,11,12 to 16, 18,19, as shown in red on the attached sketch.

READ FOR THE FIRST TIME THIS 11 DAY OF Sept, 1995

i d e  
MAYOR

[Signature]  
SENIOR ADMINISTRATIVE OFFICER

READ FOR A SECOND TIME THIS 11 DAY OF Sept, 1995


i d e  
MAYOR

[Signature]  
SENIOR ADMINISTRATIVE OFFICER


READ FOR A THIRD AND FINAL TIME THIS 17 DAY OF October, 1995

i d e  
MAYOR

[Signature]  
SENIOR ADMINISTRATIVE OFFICER

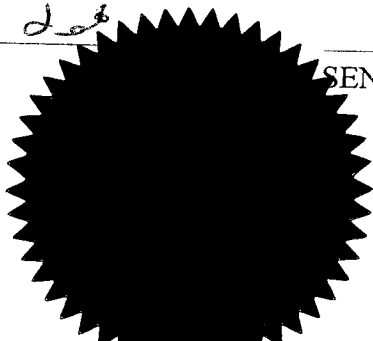

*Bylaw #362*

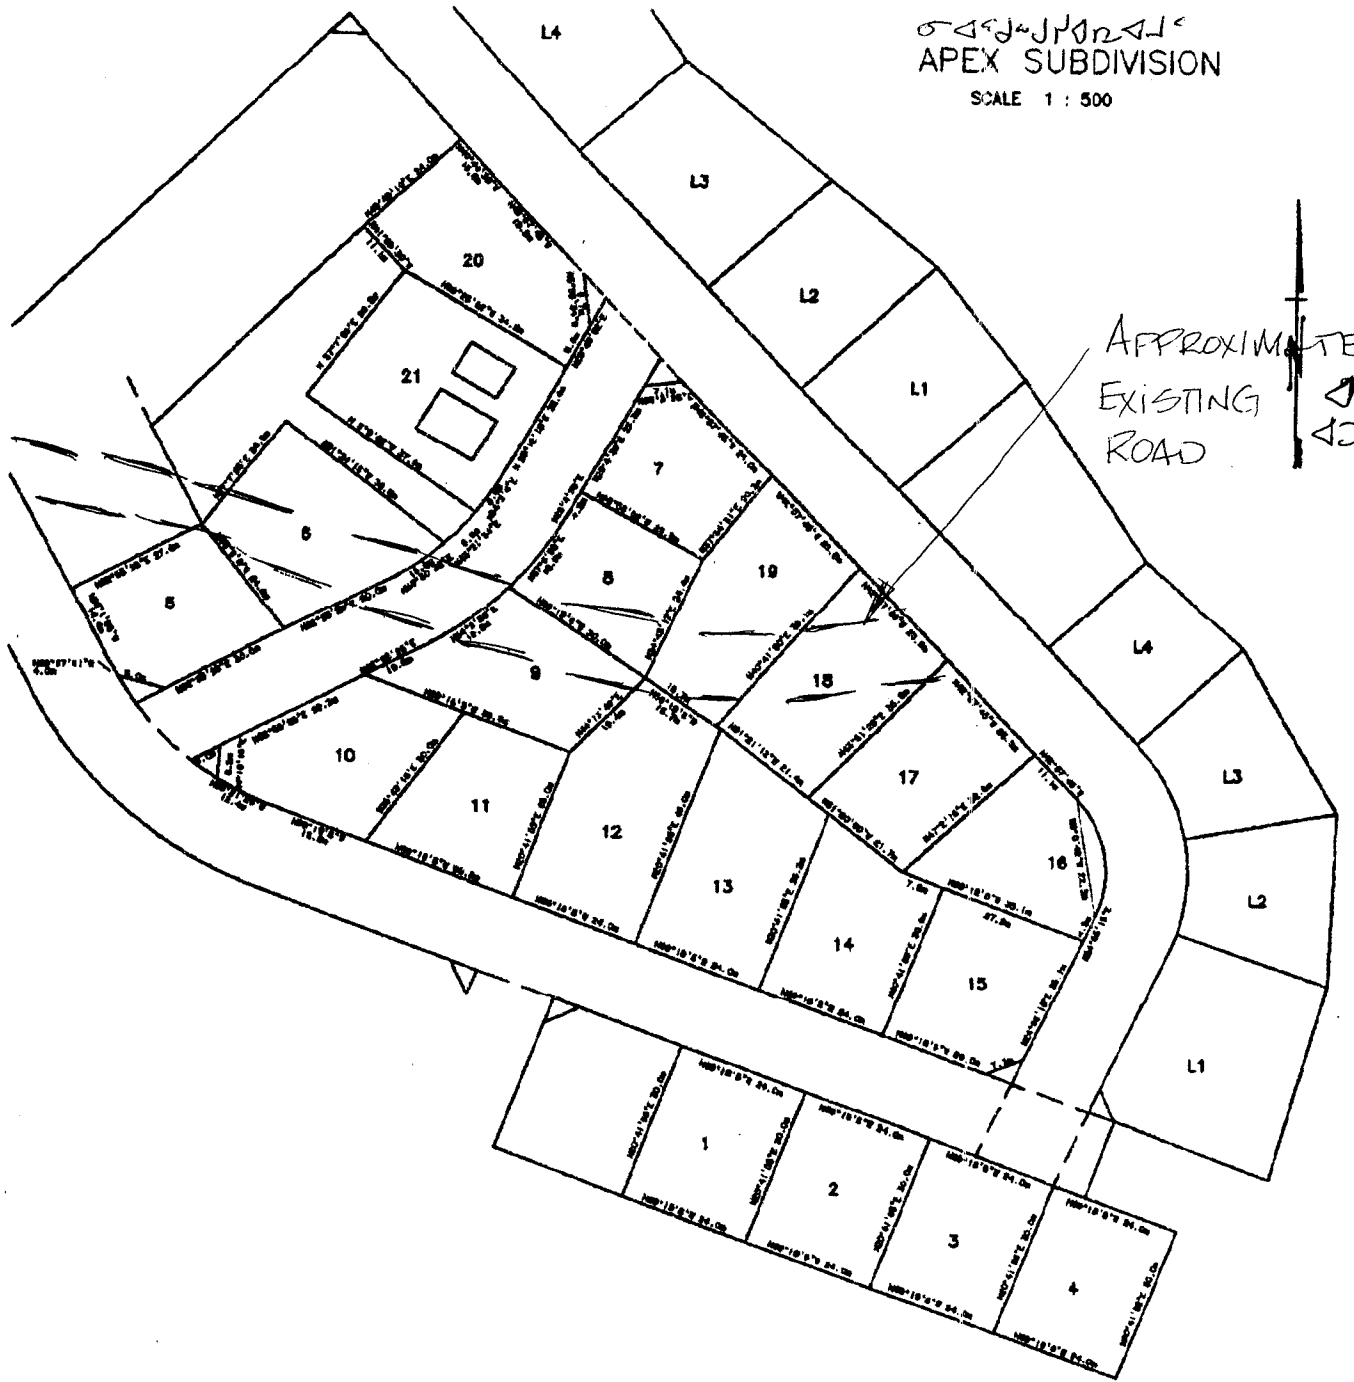

5454 JORDAN  
APEX SUBDIVISION  
SCALE 1 : 500

APPROXIMATE  
EXISTING  
ROAD

30°  
40°

Tue Jun 20 02:33:55 1995

ITEM 5b